


EXHIBIT-A

BALTIMORE CITY SUPERIOR COURT (Land Records) MLP 8721, p. 0406, MSA, CE168, 8729, Date available 06/13/2006. Printed 12/31/2018.

~~8721~~ ~~406~~

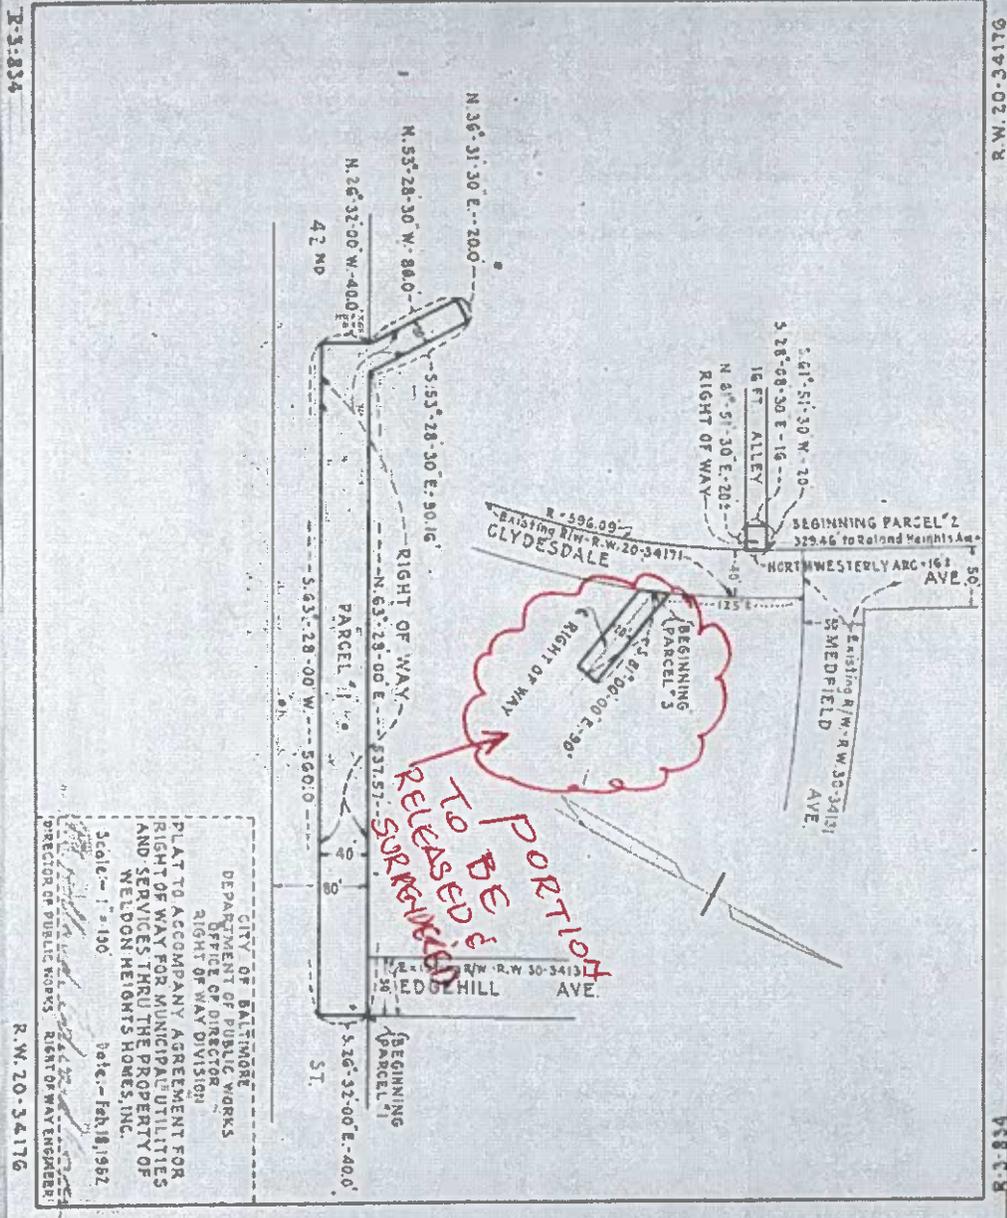

CITY OF BALTIMORE
 DEPARTMENT OF PUBLIC WORKS
 OFFICE OF DIRECTOR
 RIGHT OF WAY DIVISION
 PLAT TO ACCOMPANY AGREEMENT FOR
 RIGHT OF WAY FOR MUNICIPAL UTILITIES
 AND SERVICES THRU THE PROPERTY OF
 WELDON HEIGHTS HOMES, INC.
 Scale: 1" = 100'
 Date: Feb. 18, 1952
 DIRECTOR OF PUBLIC WORKS, RIGHT OF WAY ENGINEER

REC'D FOR RECORD FEB 28 1952 11 A M. & RECORDED IN THE LAND RECORDS OF
 BALTIMORE CITY, LIBER M. L. P. 8721 PAGE 404 M. LUTHER PITTMAN, CLERK